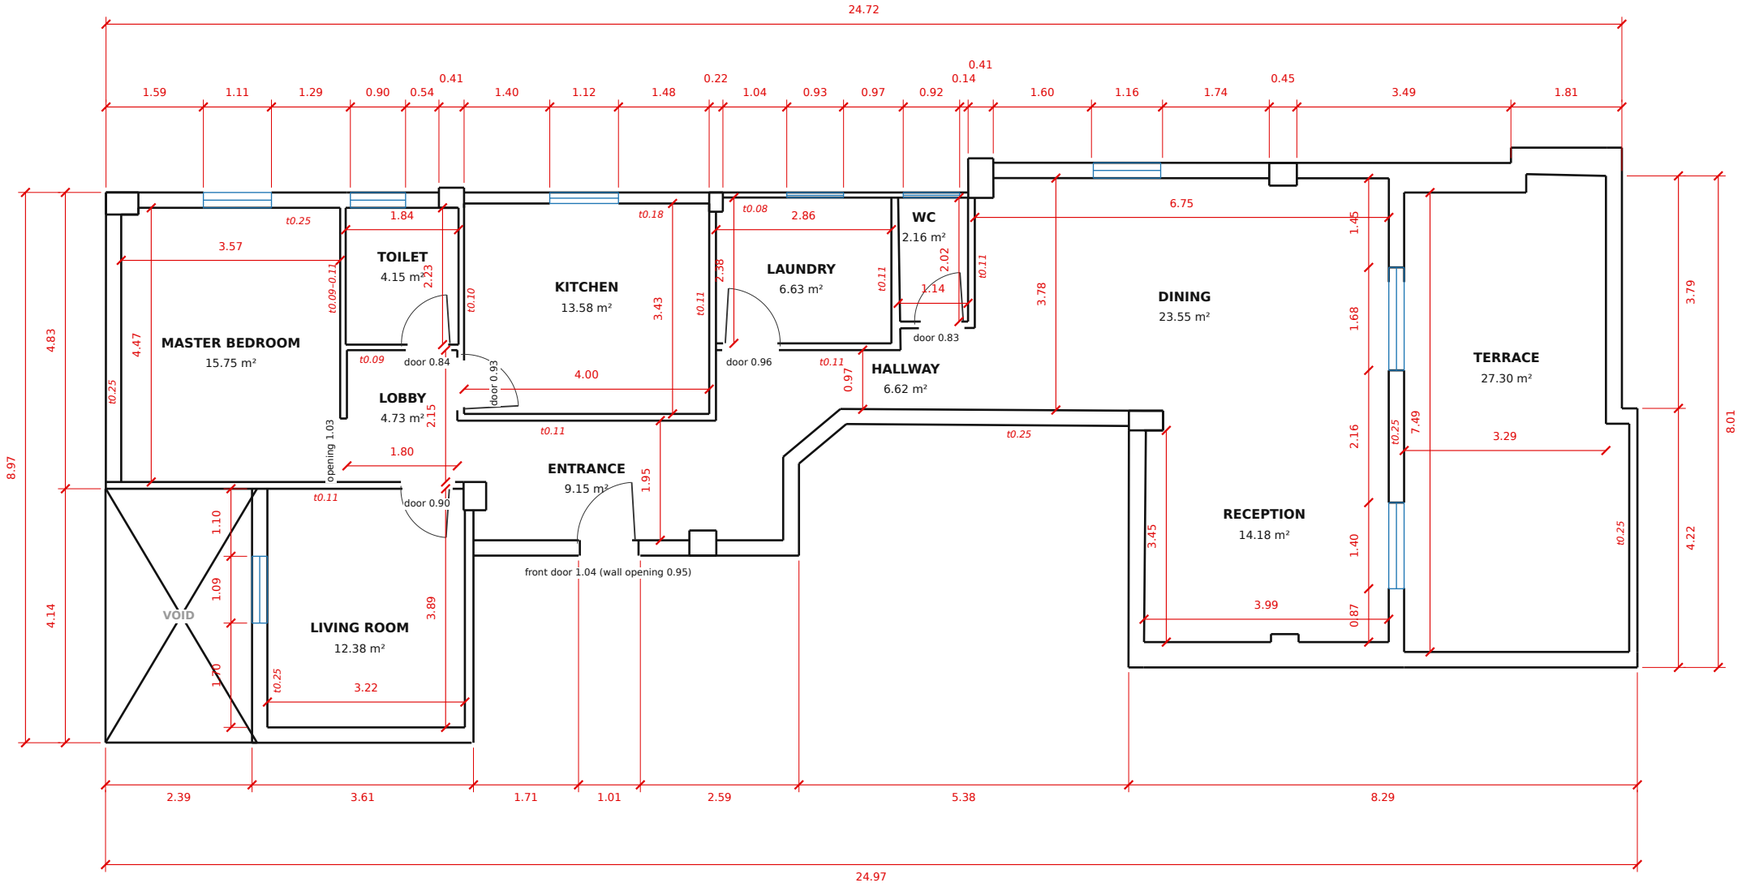



N

**PLAN NORTH**
(+Y, project convention)
**TRUE NORTH TO BE CONFIRMED**

# 1 AS-BUILT PLAN

K01

SCALE 1:100

SCALE BAR 1:100 (A3)

0 1 2 3 4 5 m

**Notes on this sheet:**

- Survey dimensions re-drawn from dwg/as-built.dxf; inner dims are face to face.
- Room names are today's use (as relabelled in the As-built 3D version).
- Wall thicknesses (t) as surveyed; internal partitions vary 0.08–0.11.
- Door widths = surveyed door block (leaf + frame); wall openings may be smaller — verify.
- Ceiling height not surveyed (model value 2.60 m).
- Columns are drawn as surveyed (no hatch); confirm sizes on site.

**ROOM AREAS (net, from geometry)**

| ROOM (today's use) | NET AREA m² |
|---|---|
| Master Bedroom | 15.75 |
| Toilet | 4.15 |
| Lobby | 4.73 |
| Kitchen | 13.58 |
| Laundry | 6.63 |
| WC | 2.16 |
| Living Room | 12.38 |
| Entrance | 9.15 |
| Hallway | 6.62 |
| Dining | 23.55 |
| Reception | 14.18 |
| **Total indoor (net)** | **112.88** |
| Terrace | 27.30 |

**GENERAL NOTES:**

1. All dimensions in metres (m), areas in m², unless noted. Do not scale from this drawing.
2. Contractor to verify all dimensions and levels on site before starting and report any discrepancy before work.
3. Base: surveyor's AS BUILT PLAN (Sep 2026, dwg/as-built.dxf) and the project model (dwg/shifted-bedroom.dxf), same coordinate frame.
4. Wall height taken as 2.60 m (project model ceiling height; not surveyed) for areas.
5. Structural engineer to confirm any removal, opening or new wall at or near columns or possibly load-bearing walls before work. No structural element may be cut without written approval.
6. Any façade / window change needs Al Lotus approval and a structural check.
7. Room areas: net floor area inside wall faces, from the model geometry; open-plan zones are split at notional lines.
8. North: plan north (+Y) is the project convention; true north to be confirmed.

**LEGEND:**

- Existing wall (survey linework)
- Window / terrace slider
- Door leaf and swing
- 1.23 Dimension (m), red; t = wall thickness
- **ROOM** Room name (today's use) and net floor area (m²)
- X in box: void (as drawn by the survey, not part of the flat)

**REVISIONS:**

| REV | DATE | DESCRIPTION |
|---|---|---|
| **A** | OCT 2026 | First issue (K01–K04 set) |

CLIENT / BUILDING APPROVAL STAMP:

DESIGNED BY:
**Karim Tamer — design**
(drawn from the project model)

location :
AL LOTUS
NEW CAIRO

PROJECT :
PRIVATE APARTMENT

DRAWING TITLE :
**AS-BUILT PLAN**
Existing condition — empty flat (survey Sep 2026)

ARCHITECTURE

| AREA: | DATE: |
|---|---|
| NEW CAIRO | OCT 2026 |

SCALE: **1:100 @ A3 (420 x 297)**

| DRAWN BY: | CHECKED BY: |
|---|---|
| K. TAMER | — |

| STATUS: | REV.: | SHEET NO.: |
|---|---|---|
| FOR REVIEW | **A** | **K01** |