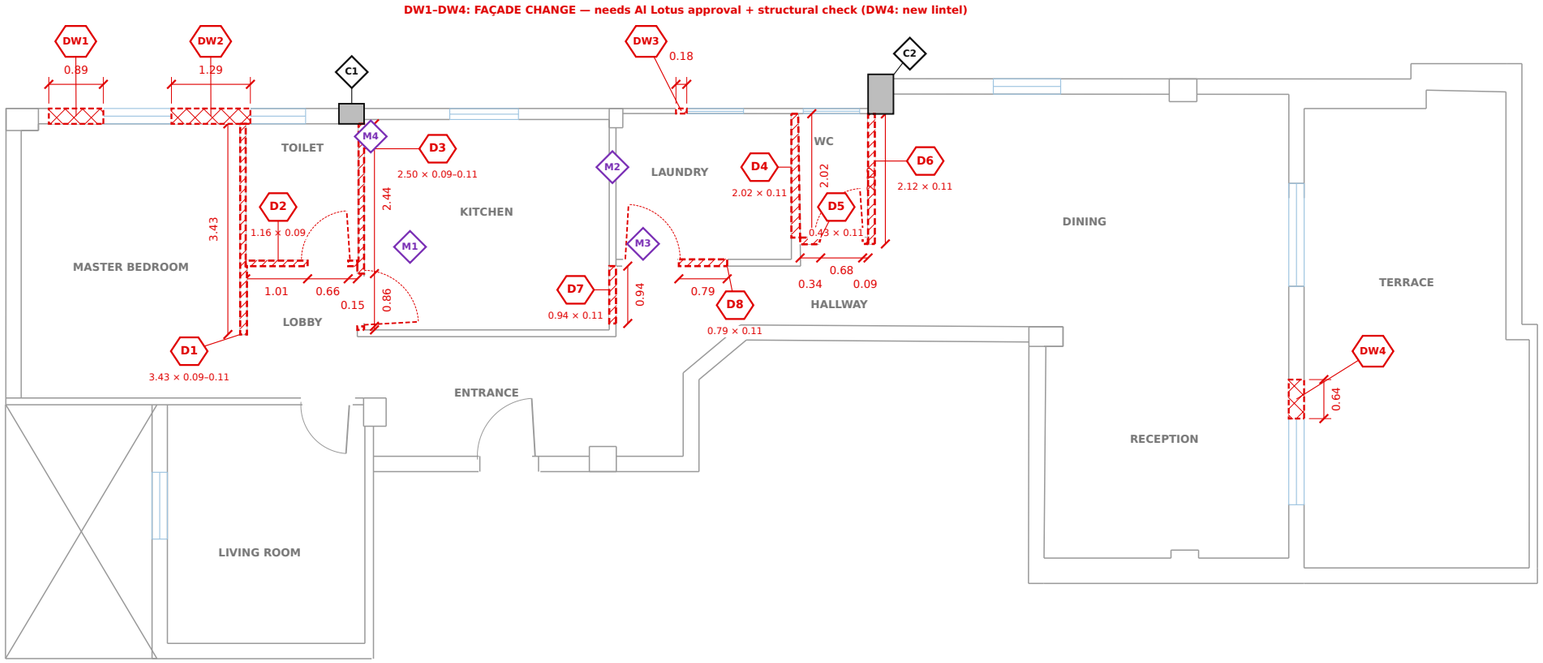


N

PLAN NORTH
(+Y, project convention)
TRUE NORTH TO BE CONFIRMED

2 DEMOLITION PLAN (ON AS-BUILT)

K02

SCALE 1:100

SCALE BAR 1:100 (A3)

0 1 2 3 4 5 m

DEMOLITION SCHEDULE

TAG	ELEMENT TO DEMOLISH	L (m)	t (m)	H (m)	AREA m²	NOTE
D1	Bedroom east wall (bedroom / toilet + lobby)	3.43	0.09–0.11	2.60	8.92	
D2	Toilet south wall incl. 0.84 door + frame	1.16	0.09	2.60	3.02	
D3	Toilet / kitchen wall incl. 0.93 kitchen door + frame	2.50	0.09–0.11	2.60	6.50	STRUCTURAL ENGINEER TO CONFIRM (abuts column C1)
D4	Laundry / WC partition	2.02	0.11 *	2.60	5.25	
D5	WC south wall incl. 0.83 door + frame	0.43	0.11	2.60	1.12	
D6	WC east wall	2.12	0.11	2.60	5.51	STRUCTURAL ENGINEER TO CONFIRM (abuts column C2)
D7	New kitchen door opening in east wall (cut + lintel)	0.94	0.11	2.10	1.97	STRUCTURAL ENGINEER TO CONFIRM (new opening, lintel)
D8	New laundry door opening in corridor wall (cut + lintel)	0.79	0.11	2.10	1.66	STRUCTURAL ENGINEER TO CONFIRM (new opening, lintel)
	Subtotal walls + new door openings	**13.39**			**33.95**	
DW1	New master-bathroom window	0.89	0.25	1.20	1.07	FAÇADE CHANGE — needs Al Lotus approval + structural check
DW2	Bedroom window widened (old toilet window)	1.29	0.25	1.20	1.55	FAÇADE CHANGE — needs Al Lotus approval + structural check
DW3	Laundry window moved 0.18 W (cut)	0.18	0.08	1.20	0.22	FAÇADE CHANGE — needs Al Lotus approval + structural check
DW4	Reception sofa window widened 1.40 → 2.00 (cut 0.64 N)	0.64	0.25	1.20	0.77	FAÇADE CHANGE — needs Al Lotus approval + structural check (new lintel)
	Subtotal façade window openings	**3.00**			**3.60**	
	TOTAL REMOVED	**16.39**			**37.55**	**length along walls; area = L × H**

H = 2.60 m wall height (project model ceiling, not surveyed); door openings to the 2.10 m door head (lintel stays); window openings 1.20 m (model sill 0.90 – head 2.10). Verify on site.

* D4: the 3 cm drafting skew of survey face 116 is ignored. Door leaves/frames in D2, D3, D5 removed with the wall; old laundry door is infilled (K03 N7).

SURVEY vs DESIGN DISCREPANCIES (not intended changes — verify on site)

M1 Kitchen west face: survey x 196.551, design 196.880 (line 97, shared by all design versions): 0.33 m

M2 Kitchen east wall: survey x 200.548–200.658, design 200.615–200.725: 0.07 m E

M3 Corridor N wall (laundry S): survey y −114.803/−114.913, design −114.724/−114.834: 0.08 m N

M4 North wall inner face x 196.55–196.77: survey y −112.523, design −112.593: 0.07 m

Schedules take removed pieces from the survey and new walls from the design; the offsets above are drafting differences between the two drawings, so they are listed, not scheduled.

GENERAL NOTES:

1. All dimensions in metres (m), areas in m², unless noted. Do not scale from this drawing.
2. Contractor to verify all dimensions and levels on site before starting and report any discrepancy before work.
3. Base: surveyor's AS BUILT PLAN (Sep 2026, dwg/as-built.dxf) and the project model (dwg/shifted-bedroom.dxf), same coordinate frame.
4. Wall height taken as 2.60 m (project model ceiling height; not surveyed) for areas.
5. Structural engineer to confirm any removal, opening or new wall at or near columns or possibly load-bearing walls before work. No structural element may be cut without written approval.
6. Any façade / window change needs Al Lotus approval and a structural check.
7. Room areas: net floor area inside wall faces, from the model geometry; open-plan zones are split at notional lines.
8. North: plan north (+Y) is the project convention; true north to be confirmed.

LEGEND:

- Existing wall to remain (survey), thin grey
- Wall / piece to be DEMOLISHED (red dashed, hatched)
- Façade: new / widened window opening to cut
- Door leaf + frame to remove
- Demolition tag (see schedule); L × t in m
- Column / pier next to the work (as surveyed)
- Survey vs design discrepancy — verify, not in schedule
- 1.23 Dimension (m)

REVISIONS:

REV	DATE	DESCRIPTION
A	OCT 2026	First issue (K01–K04 set)

CLIENT / BUILDING APPROVAL STAMP:

DESIGNED BY:
Karim Tamer — design
(drawn from the project model)

location :
AL LOTUS
NEW CAIRO

PROJECT :
PRIVATE APARTMENT

DRAWING TITLE :
DEMOLITION PLAN
Walls to remove: as-built → Shifted Bedroom design

ARCHITECTURE

AREA:	DATE:
NEW CAIRO	OCT 2026

SCALE:
1:100 @ A3 (420 x 297)

DRAWN BY:	CHECKED BY:
K. TAMER	—

STATUS:	REV.:	SHEET NO.:
FOR REVIEW	**A**	**K02**