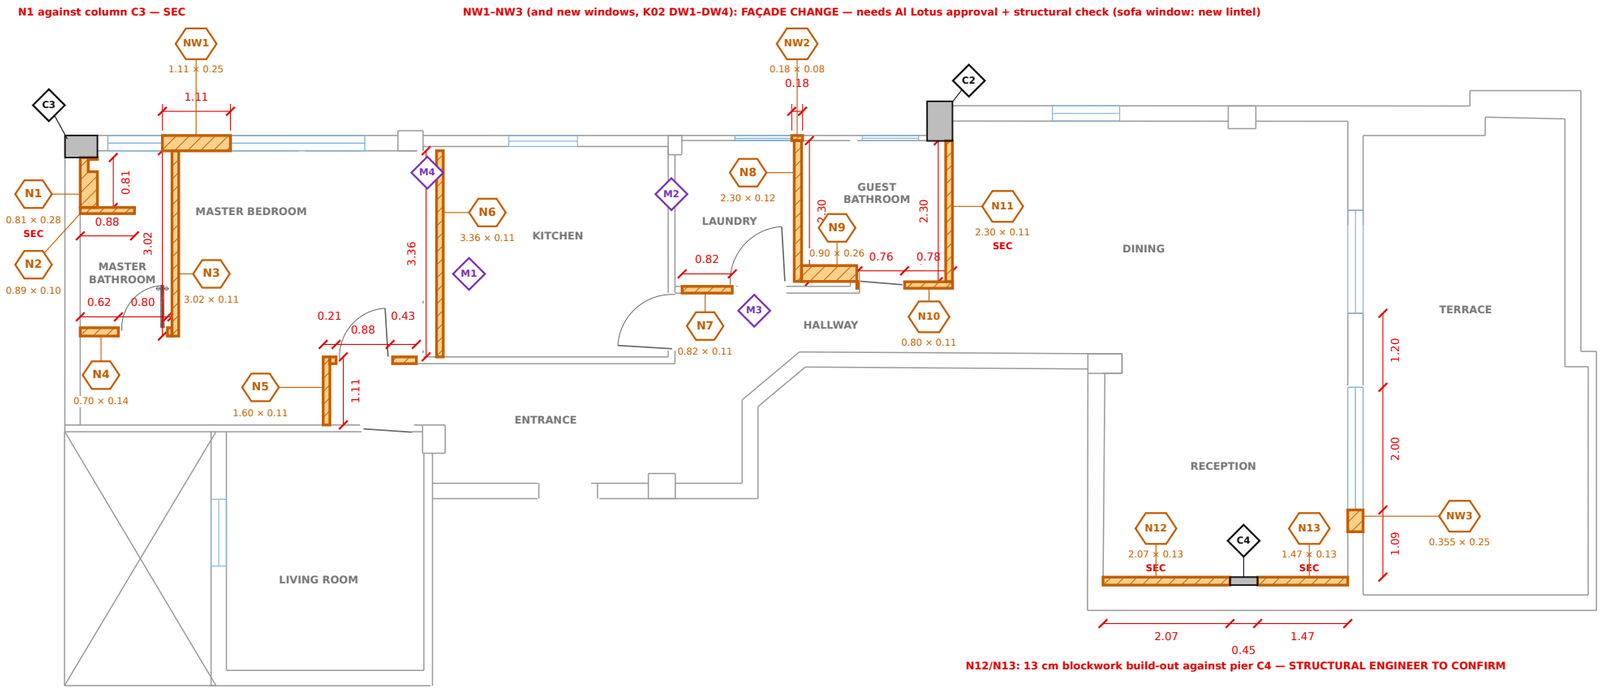


N

PLAN NORTH
(+Y, project convention)
TRUE NORTH TO BE CONFIRMED

3 NEW WALL PLAN (DESIGN)

K03

SCALE 1:100

SCALE BAR 1:100 (A3)

0 1 2 3 4 5 m

NEW WALL SCHEDULE

TAG	NEW WALL / INFILL	L (m)	t (m)	H (m)	AREA m²	NOTE
N1	Master shower back-wall build-out (niche stack 0.20 x 0.15 recess)	0.81	0.28	2.60	2.11	STRUCTURAL ENGINEER TO CONFIRM (against column C3)
N2	Master shower partition	0.89	0.10	2.60	2.31	
N3	Bathroom / bedroom partition	3.02	0.11	2.60	7.85	
N4	Bathroom south wall (0.80 door)	0.70	0.14	2.60	1.82	
N5	Bedroom / corridor wall (0.88 door)	1.60	0.11	2.60	4.16	
N6	Kitchen west wall, relocated 0.33 E (closes west kitchen door)	3.36	0.11	2.60	8.74	see M1
N7	Infill old laundry door	0.82	0.11	2.10	1.72	
N8	Laundry / WC partition (0.92 m W of old)	2.30	0.12	2.60	5.98	
N9	Guest-bath end wall (bath foot)	0.90	0.26	2.60	2.34	
N10	WC south wall (0.76 door)	0.80	0.11	2.60	2.08	
N11	WC east wall, 0.30 E of old	2.30	0.11	2.60	5.98	STRUCTURAL ENGINEER TO CONFIRM (abuts column C2)
N12	Reception build-out W of pier (blockwork)	2.07	0.13	2.60	5.38	STRUCTURAL ENGINEER TO CONFIRM (against pier C4)
N13	Reception build-out E of pier (blockwork)	1.47	0.13	2.60	3.82	STRUCTURAL ENGINEER TO CONFIRM (against pier C4)
	Subtotal new walls + door infill	**21.04**			**54.29**	
NW1	Infill old bedroom window	1.11	0.25	1.20	1.33	FAÇADE CHANGE — needs Al Lotus approval + structural check
NW2	Laundry window moved 0.18 W (infill)	0.18	0.08	1.20	0.22	FAÇADE CHANGE — needs Al Lotus approval + structural check
NW3	Reception sofa window: S infill (new jamb 0.355 N)	0.355	0.25	1.20	0.43	FAÇADE CHANGE — needs Al Lotus approval + structural check (new lintel)
	Subtotal façade window infills	**1.65**			**1.97**	
	TOTAL NEW	**22.68**			**56.27**	**length along walls; area = L × H**

H = 2.60 m (project model ceiling, not surveyed); N7 door infill to the 2.10 m door head; window infills 1.20 m (model sill 0.90 – head 2.10).

Material TBC except N12/N13 (blockwork, 13 cm > 10 cm drywall limit).

N6 relocates the kitchen west wall 0.33 m E and so closes the old west kitchen door (K02 D3); the new kitchen door is cut in the east wall (K02 D7).

Master shower: 1.216 × 0.924 m inside N1 / N2 / N3.

DISCREPANCIES (verify on site; full text on K02)

M1 Kitchen west face: survey x 196.551, design 196.880 (line 97, shared by all design versions): 0.33 m

M2 Kitchen east wall: survey x 200.548–200.658, design 200.615–200.725: 0.07 m E

M3 Corridor N wall (laundry S): survey y −114.803/−114.913, design −114.724/−114.834: 0.08 m N

M4 North wall inner face x 196.55–196.77: survey y −112.523, design −112.593: 0.07 m

New walls are drawn at the design's coordinates; M1–M3 mean they may land up to 0.33 m (M1) / 0.08 m (M2, M3) off the surveyed walls. Set out from the survey on site.

GENERAL NOTES:

1. All dimensions in metres (m), areas in m², unless noted. Do not scale from this drawing.
2. Contractor to verify all dimensions and levels on site before starting and report any discrepancy before work.
3. Base: surveyor's AS BUILT PLAN (Sep 2026, dwg/as-built.dxf) and the project model (dwg/shifted-bedroom.dxf), same coordinate frame.
4. Wall height taken as 2.60 m (project model ceiling height; not surveyed) for areas.
5. Structural engineer to confirm any removal, opening or new wall at or near columns or possibly load-bearing walls before work. No structural element may be cut without written approval.
6. Any façade / window change needs Al Lotus approval and a structural check.
7. Room areas: net floor area inside wall faces, from the model geometry; open-plan zones are split at notional lines.
8. North: plan north (+Y) is the project convention; true north to be confirmed.

LEGEND:

- Existing wall to remain (survey), thin grey
- NEW wall / infill (all new construction: filled + hatched)
- Window in the design (new positions on the north façade)
- Door in the design (leaf + swing)
- New-wall tag (see schedule); L × t in m
- SEC — STRUCTURAL ENGINEER TO CONFIRM (touches column / pier)
- Column / pier next to the work (as surveyed)
- Survey vs design discrepancy — verify (see K02)
- 1.23 — Dimension (m)

REVISIONS:

REV	DATE	DESCRIPTION
A	OCT 2026	First issue (K01–K04 set)

CLIENT / BUILDING APPROVAL STAMP:

DESIGNED BY:
Karim Tamer — design
(drawn from the project model)

location :
AL LOTUS
NEW CAIRO

PROJECT :
PRIVATE APARTMENT

DRAWING TITLE :
NEW WALL PLAN
New walls + infills: as-built → Shifted Bedroom design

ARCHITECTURE

AREA:	DATE:
NEW CAIRO	OCT 2026

SCALE:
1:100 @ A3 (420 x 297)

DRAWN BY:	CHECKED BY:
K. TAMER	—

STATUS:	REV.:	SHEET NO.:
FOR REVIEW	**A**	**K03**